

**SUBMITTAL TO THE FLOOD CONTROL AND
WATER CONSERVATION DISTRICT
BOARD OF SUPERVISORS
COUNTY OF RIVERSIDE, STATE OF CALIFORNIA**



ITEM: 11.1
(ID # 15135)

MEETING DATE:
Tuesday, May 25, 2021

FROM: FLOOD CONTROL DISTRICT:

SUBJECT: FLOOD CONTROL DISTRICT: Approve Change Order, Contract Increase, and Notice of Completion for Ortega Channel Retrofit, Stage 91, Project No. 3-0-00070-91, District 1. [\$433,443 Total Cost - District funds 100%] (4/5 Vote Required)

RECOMMENDED MOTION: That the Board of Supervisors:

1. Approve Change Order No. 1 in the amount of \$440,000 for Ortega Channel Retrofit, Stage 91 (Project) for the removal and disposal of existing cast-in-place pipe, an integral part of the project work, and authorize the Chair of the Board of Supervisors for the District (Board) to execute the attached Change Order No. 1 on behalf of the Riverside County Flood Control and Water Conservation District (District);
2. Approve the contract increase of \$433,443 for the Project for a total compensation to H&H General Contractors, Inc. (Contractor) of \$2,322,307;
3. Accept as complete the Project as constructed;
4. Authorize the Chair of the Board to execute the attached Notice of Completion;
5. Authorize the release of \$94,115 in retained funds to Contractor, in accordance with the contract terms and applicable law; and
6. Direct the Clerk of the Board to record the executed Notice of Completion with the Riverside County Clerk and Recorder's Office and return a copy of the recorded document to the District.

ACTION: 4/5 Vote Required, Policy

Jason Uhley, GENERAL MGR-CHF FLD CNTRL ENG

5/12/2021

MINUTES OF THE BOARD OF SUPERVISORS

On motion of Supervisor Perez, seconded by Supervisor Hewitt and duly carried by unanimous vote, IT WAS ORDERED that the above matter is approved as recommended.

Ayes: Jeffries, Spiegel, Washington, Perez, and Hewitt
Nays: None
Absent: None
Date: May 25, 2021
xc: Flood, Recorder

Kecia R. Harper
Clerk of the Board

By:
Deputy

**SUBMITTAL TO THE FLOOD CONTROL AND WATER CONSERVATION DISTRICT BOARD
OF SUPERVISORS
COUNTY OF RIVERSIDE, STATE OF CALIFORNIA**

FINANCIAL DATA	Current Fiscal Year:	Next Fiscal Year:	Total Cost:	Ongoing Cost
COST	\$ 433,443	\$ 0	\$ 433,443	\$ 0
NET COUNTY COST	\$ 0	\$ 0	\$ 0	\$ 0
SOURCE OF FUNDS: 25130-947440-548200 Zone 3 Infrastructure			Budget Adjustment: No	
			For Fiscal Year: 20/21	

C.E.O. RECOMMENDATION: Approve

BACKGROUND:

Summary

The Board approved a contract with Contractor in the amount of \$1,888,864 as Agenda Item Number 11.1 (MT#12532) on June 9, 2020. A brief project description and location map is attached.

A critical component of this Project was the removal of 600 feet of an existing 8-foot diameter storm drain pipe to allow placement of the new system that will allow improved maintenance access. During construction, it was found that the existing storm drain was of different character than what was shown on the plans. The pipe walls were approximately three times thicker than standard reinforced concrete pipe and required significant additional time and effort to remove and dispose. Staff negotiated an appropriate price with the Contractor for this change in conditions, which resulted in attached Change Order No. 1.

Final inspection of the Project was made, and the Project was found to be complete according to the plans and specifications. The final price for the Project is \$2,322,307, including all contract work and additional work associated with Change Order No. 1. This final price is \$433,443 above the original contract amount. The total additional cost is less than the change order due to other contract items that came in slightly under budget. See also the Additional Fiscal Information section below.

Prev. Agn. Ref.: MT#11847 11.1 of 02/25/20 (Advertise/CEQA Exempt)
MT#12532 11.1 of 06/09/20 (Award)

Impact on Residents and Businesses

This Project replaced a portion of an existing underground pipe with an underground reinforced concrete box with three maintenance access portals. The replacement will reduce maintenance costs and increase the Project's resilience to long-standing sediment plugging issues.

Additional Fiscal Information

**SUBMITTAL TO THE FLOOD CONTROL AND WATER CONSERVATION DISTRICT BOARD
OF SUPERVISORS
COUNTY OF RIVERSIDE, STATE OF CALIFORNIA**

Pursuant to MT#12532, Agenda Item Number 11.1 on June 9, 2020, the Board previously approved a contract with Contractor for \$1,888,864. The final Project cost accounting is summarized in the table below.

	Original Contract	Final Price
Contract Work	\$1,888,864	\$1,882,307
Change Order No. 1	N/A	\$440,000
Total	\$1,888,864	\$2,322,307

Upon approval of the motions on this item, the total payments for this Project will consist of \$2,322,307 to the Contractor. Sufficient funds are available within the District's existing budget to cover the increase in total compensation. No budget adjustments are necessary.

Contract History and Price Reasonableness

Pursuant to Public Contract Code 21091, invitation of sealed bids was solicited by advertising in print and digital media.

The final price for the Project is \$2,322,307, which is \$433,443 above the original contract amount. The increase in costs due to Change Order No. 1 were negotiated with the Contractor to a fair price in accordance with Section 2.07 of the contract General Provisions.

ATTACHMENTS:

1. Change Order No. 1
2. Notice of Completion
3. Project Description and Location Map

P8\237789



Jason Farrin, Principal Management Analyst 5/18/2021



Gregory V. Priamos, Director County Counsel 5/13/2021

RIVERSIDE COUNTY FLOOD CONTROL AND WATER CONSERVATION DISTRICT

Project Name: Ortega Channel Retrofit, Stage 91

Sheet 1 of 2

Project No.: 3-0-00070-91

CONTRACT CHANGE ORDER NO. 1

To **H&H General Contractors, Inc.**, Contractor you are hereby directed to make the herein described changes from the plans and specifications or to do the following described work not included in the plans and specifications.

NOTE: THIS CHANGE ORDER IS NOT EFFECTIVE UNTIL APPROVED AND EXECUTED BY THE GENERAL MANAGER-CHIEF ENGINEER, IF APPLICABLE SIGNATURE AUTHORITY APPROVAL HAS BEEN GRANTED BY BOARD ORDER OR THE BOARD OF SUPERVISORS OF THE DISTRICT.

Description of work to be done, estimate of quantities, and prices to be paid. Unless otherwise stated, rates for rental of equipment cover only such time as equipment is actually used and no allowance will be made for idle time. Change requested by District.

The Ortega Channel Retrofit, Stage 91 project (project) consists of demolishing an existing underground storm drain and replacing it with 12-feet by 10-feet precast reinforced concrete box. The contract documents showed the existing storm drain as a 'reinforced concrete pipe' (RCP). The District's Contractor, H&H General Contractors, Inc. (Contractor), began removal of the existing storm drain and discovered that the storm drain is of different character than what was shown on the plans. The storm drain is approximately 600 feet of cast-in-place pipe (CIPP) (see Exhibit 1, DWG 3-0215). The CIPP is approximately three times thicker than standard RCP and requires a substantial additional time and effort to remove and dispose. The change of conditions not only affects the time necessary to complete the work, but also changes the Contractor's intended means and methods for conducting the removal and significantly increases the quantity of material to be removed (see attached Photos 1 and 2). In good faith, the Contractor continued to work on the project and discuss a resolution for the Extra Work.

Section 2.07 of the General Provisions allows the District to add Extra Work when confronted with unpredicted conditions, unforeseen events, or emergencies. Extra Work is added work of a different character for which no basis for payment is prescribed or work which is indeterminate at the time of advertising.

Exhibit 2, Ortega Channel Retrofit, Stage 91-Change Order No. 1 Extra Work Costs, includes the Extra Work line item descriptions and costs. Change Order No. 1 represents a lump sum change order that includes all additional labor, materials, equipment, equipment repairs, hauling, and debris disposal that is needed in order to complete all the extra work associated with the change in conditions from RCP as shown on the plans to CIPP. The total proposed compensation for the Extra Work is \$440,000 and an additional 30 working days.

Table 1: Contract Cost Summary

Original Contract Cost	\$1,888,864.00
<u>Prior Authorized Change:</u>	
Increase:	\$0
Decrease:	-\$0.00
Net:	\$0
Total Contract Cost Prior to this Change Order	\$1,888,864.00
<u>Authorized Changes on this Change Order:</u>	
Increase:	\$440,000.00
Decrease:	-\$0.00
Net:	\$440,000.00
Amount of Contract Authorized Including this Change Order	\$2,328,864.00

Table 2: Contract Working Days Summary

Original Contract Duration	70 Contract Working Days
Prior Authorized Time Extensions	0 Contract Working Days
Contract Change Order 2 Time Extension	30 Contract Working Days
Revised Contract Duration	100 Contract Working Days

RIVERSIDE COUNTY FLOOD CONTROL AND WATER CONSERVATION DISTRICT

Project Name: Ortega Channel Retrofit, Stage 91

Sheet 2 of 2

Project No.: 3-0-00070-91

Submitted by: <u><i>David Garcia</i></u> DAVID GARCIA, Construction Engineer	Date: <u>2/3/21</u>
Approved by: <u><i>Jason E. Uhley</i></u> JASON E. UHLEY, General Manager-Chief Engineer	Date: <u>4/28/2021</u>
<u><i>Karen S. Spiegel</i></u> Chair, Board of Supervisors KAREN SPIEGEL	Date: <u>05/25/2021</u>

We, the undersigned Contractor, have given careful consideration to the change proposed, including its effect on other work already contracted for, and hereby agree, if this proposal is approved, that we will provide all equipment, furnish all materials, except as may be otherwise noted above, and perform all services necessary for the work above specified, and will accept as full payment for all costs related in any way thereto the prices shown above. Contractor expressly waives any contract right to pursue any further claim, including indirect or impact costs, related to this change order work.

Accepted: Date: 1-4-2021 Contractor: H&H General Contractors, Inc.

By: ~~_____~~ Title: President

If the Contractor does not sign acceptance of this order, his attention is directed to the requirements of the specifications as to the proceeding with the ordered work and filing a written protest within the time therein specified.

DHG:mcv
P8\236641

FORM APPROVED COUNTY COUNSEL
BY *Kristine Bell-Valdez* *5/16/2021*
KRISTINE BELL-VALDEZ DATE



Photo 1 - Construction worker measuring existing CIPP and 10,000 LB breaker



Photo 2 - Existing CIPP measurement

RIVERSIDE COUNTY FLOOD CONTROL AND WATER CONSERVATION DISTRICT

INDEX	
1	TITLE SHEET
2	PLAN & PROFILE STA 24+00 TO 24+00
3	PLAN & PROFILE STA 24+00 TO 24+23
4	DETAIL SHEET - 1
5	DETAIL SHEET - 2
6	DETAIL SHEET - 3
7	DETAIL SHEET - 4
8	DETAIL SHEET - 5
9	INTERIM GRADING

R.C.F.C. & W.C.D. STANDARD DRAWINGS

M4255	MANHOLE NO. 3
M4257	MANHOLE SHIRT FOR CAST PRE
M4259	STANDARD DROP STEP
M4260	24-INCH MANHOLE FRAME & COVER
M4261	TRANSITION STRUCTURE NO. 1
M814	ABBREVIATIONS AND SYMBOLS
M815	EXCAVATION AND BACKFILL PAY LINES



CALTRANS STANDARD PLANS

060	CAST-IN-PLACE REINFORCED CONCRETE SINGLE BOX CULVERT
RSP D3A1	PRECAST REINFORCED CONCRETE BOX CULVERT
RSP D3B8	PRECAST REINFORCED CONCRETE BOX CULVERT, MISCELLANEOUS DETAILS
0614	CAST-IN-PLACE REINFORCED CONCRETE JUNCTION STRUCTURE
0618	CAST-IN-PLACE REINFORCED CONCRETE JUNCTION STRUCTURE

GEOTECHNICAL REPORT

GEOTECHNICAL INVESTIGATION
RIVERSIDE COUNTY FLOOD CONTROL
ORTEGA CHANNEL RETROFIT
LINE EL SNORE CALIFORNIA
ACCOM PROJECT NO. 80995669, DATED MARCH 28, 2019

- GENERAL NOTES
- ALL STATIONING REFERS TO CENTERLINE OF CONSTRUCTION.
- THE HORIZONTAL DATA IS DERIVED FROM NAD83/STATEMAD EPOCH 2010.
- PHOTOGRAPHY BY DIGITAL PHOTOGRAMMETRIC METHODS, AERIAL PHOTOGRAPHY TAKEN AT AN ALTITUDE NOT TO EXCEED A FLIGHT HEIGHT TO OBTAIN A MINIMUM RATIO OF 80:1. PHOTOGRAPHY DATED 11/21/2017.
- THE VERTICAL DATA IS DERIVED FROM NAVD 88 (CON 88).
- AND CALIFORNIA STATE PLUMBING ZONE 8.
- STANDARD DRAWINGS CALLED FOR ON THE PLAN & PROFILE SHALL CONFORM TO RCF&C & WCD STD DRAWINGS OR CALTRANS/CITY/ COUNTY STANDARD PLANS.
- ELEVATIONS AND LOCATIONS OF UTILITIES AND STORM DRAIN WERE OBTAINED FROM AVAILABLE INFORMATION AND ARE SHOWN APPROPRIATELY ON THESE PLANS.
- SERVICE ALERT AT 1-800-227-2800. ALL UTILITIES AND STORM DRAIN SHALL BE PROTECTED IN PLACE EXCEPT AS NOTED ON PLANS AND SPECIFICATIONS.
- REWORKING TEMPORARY SUPPORT AND SHOWING REQUIREMENTS FOR THE VARIOUS UTILITY LINES SHOWN ON THESE PLANS.
- ALL RECONSTRUCTION, RESURFACING AND PAVEMENT DETERMINATION, CURBS, SIDEWALKS AND OTHER IMPROVEMENTS ARE TO BE CONSTRUCTION IMPROVEMENTS, UNLESS OTHERWISE NOTED.
- INDICATES APPROX. SOIL BORING LOCATION PER SOILS REPORT DATED 03/28/2019.
- EXISTING "DO", "98", AND "84" STORM DRAINS ARE KNOWN TO HAVE SEWAGE WITHIN THE PAPER EXISTING STORM DRAIN REMOVAL SHALL INCLUDE REMOVAL OF AN ESTIMATED 400 C.Y. OF SEDIMENT.

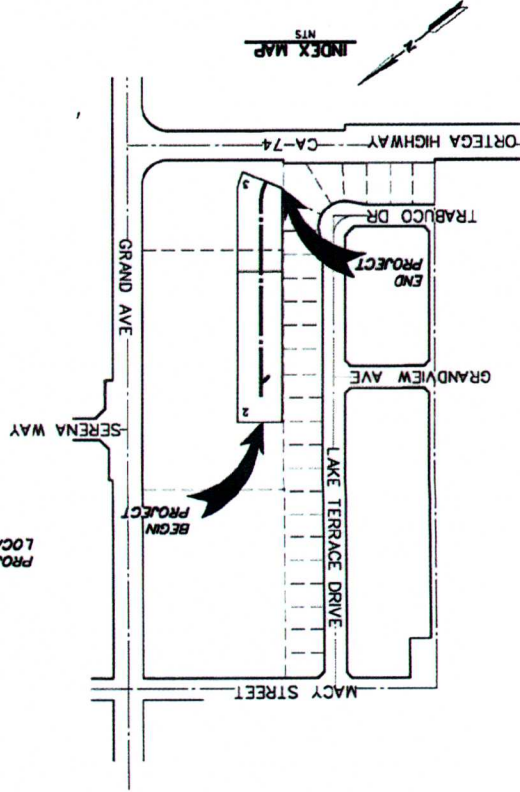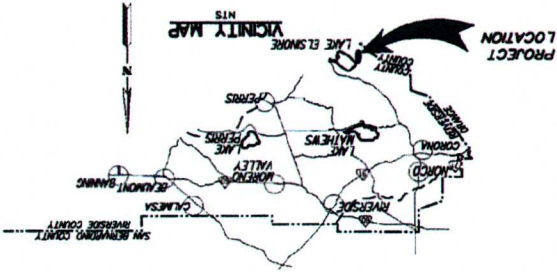

DATE: JULY 22, 2019 PROJECT: ORTEGA CHANNEL RETROFIT STAGE 91 SHEET NO.: 3-0215 DRAWING NO.: 3-0-00070-91	TITLE SHEET ORTEGA CHANNEL RETROFIT STAGE 91	REVISIONS NO. DATE BY DESCRIPTION 01 11/22/19 DG 11/22/19 REVISE RFP TO CIP	PROJECT NO.: 80995669 DATE: 03/28/2019 PROJECT NAME: ORTEGA CHANNEL RETROFIT LOCATION: LINE EL SNORE CALIFORNIA	DRAWING NO.: 3-0-00070-91 SHEET NO.: 3-0215 TITLE SHEET	AECOM Imagine It. Delivered. 11-11-14-001-2001 San Diego, CA 92161 USA www.aecom.com

Exhibit 1 - Change Order 1



CONSTRUCTION DRAWING SET DATED JULY 22, 2019



REVISIONS
 NO. DATE DESCRIPTION
 1 12/22/19 REVISE RCP TO CIPP
 2 1/24/2019
 3 1/24/2019
 4 1/24/2019
 5 1/24/2019
 6 1/24/2019
 7 1/24/2019
 8 1/24/2019
 9 1/24/2019

PROJECT NO. 15-070
 STA 26+23
 DATE 1/24/2019
 DRAWN BY: J. PLAZA
 CHECKED BY: J. PLAZA
 DATE 1/24/2019
 PROJECT NO. 15-070
 STA 26+23

PROJECT NO. 15-00070-91
 DRAWING NO. 3-0215
 SHEET NO. 3 OF 9
ORTEGA CHANNEL RETROFIT STAGE 91
 STA 24+00 TO STA 26+23
 WATER CONSERVATION DISTRICT
 AND
 BENTON COUNTY FLOOD CONTROL
 DATE 1/24/2019

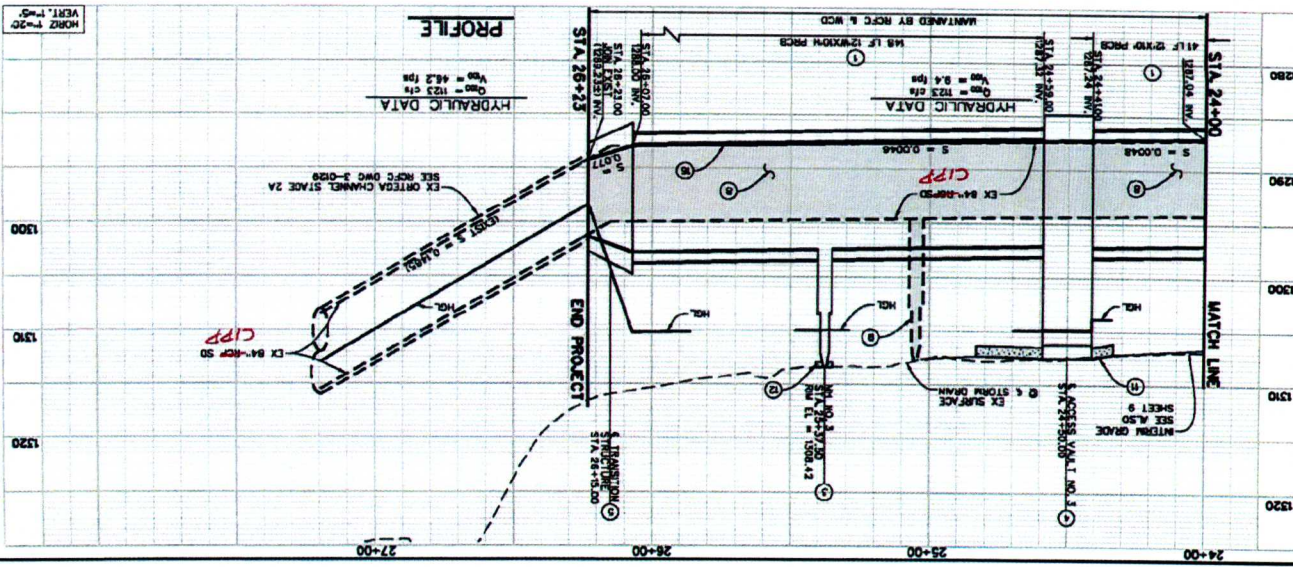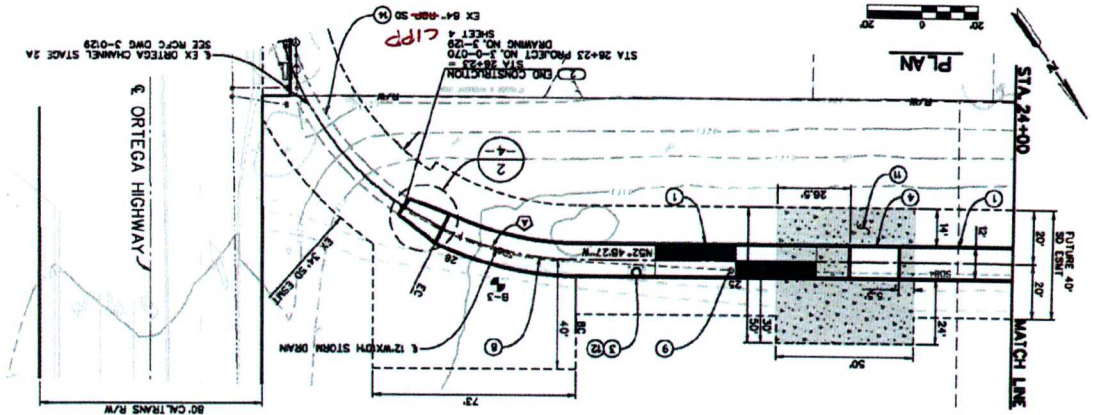




- NOTES**
1. FURNISH AND INSTALL 12" X 24" MODIFIED PRECAST RCP PER CALLINGS STANDARD PLAN RSP DATA AND PER DETAIL 1 ON SHEET 4.
 2. CONSTRUCT MH NO. 3 PER RCP/CAND STD W4253.
 3. CONSTRUCT ACCESS VAULT PER DETAIL 4 ON SHEET 6.
 4. CONSTRUCT MODIFIED RCP/CAND STD TRANSITION STRUCTURE PER DETAIL 2 ON SHEET 4.
 5. REMOVE EXISTING 84" STORM DRAIN AND SEWAGE.
 6. REMOVE EXISTING MANHOLE NO. 2.
 7. CONSTRUCT 12" THICK RCP PAD #4 @ 12" EACH WAY PER DETAIL 1 ON SHEET 6.
 8. CONSTRUCT 6" X 6" X 6" PCC PAD #4 @ 12" EACH WAY PER DETAIL 2 ON SHEET 6.
 9. PROTECT IN PLACE.
 10. REMOVE EXISTING STEEL AS SCOUR PROTECTION.

P. I.	EXISTING	6278788.87
E. C.	NORTHING	2184782.35
B. C.	EASTING	26+07.00
T		25+37.37
L		25.34
R		49.63
CURVE DATA		
R=25.34		
L=49.63		
T=25.34		
E. C. = 26+07.00		
NORTHING = 2184782.35		
EASTING = 6278788.87		













PT	NORTHING	EASTING	DESCRIPTION
1	2184745.11	6278808.51	END SD RETROFIT

MANHOLE / JUNCTION STRUCTURE DATA	LATERAL	STATION	WALL STATION STRUCTURE	A	C
		26+27.50			

STORM DRAIN SURVEY CONTROL	FL	DESCRIPTION
		26+07.00

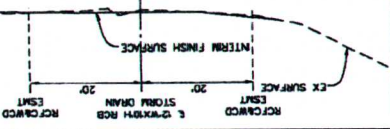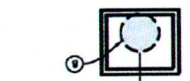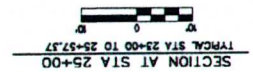

CONSTRUCTION DRAWING SET DATED JULY 22, 2019

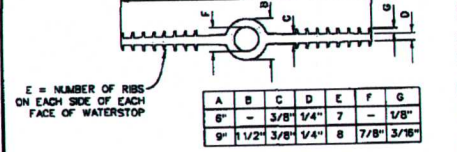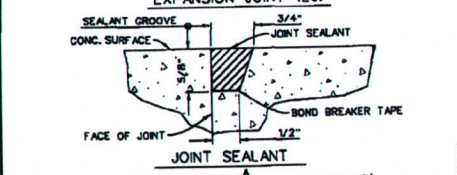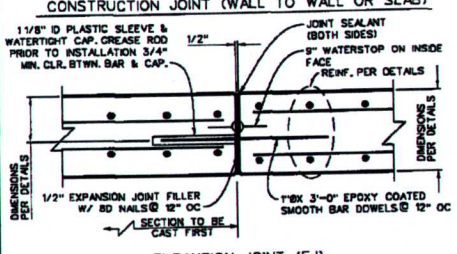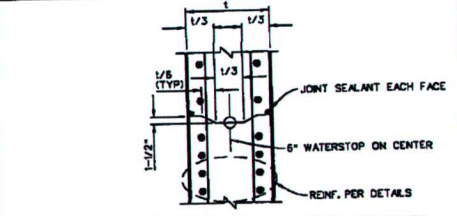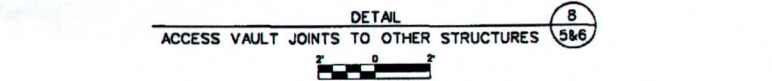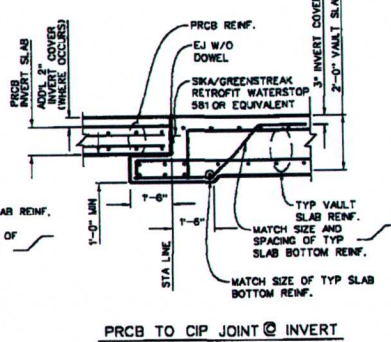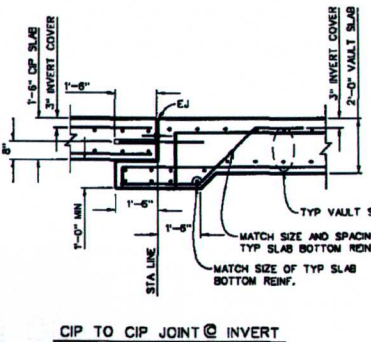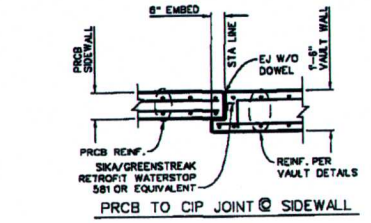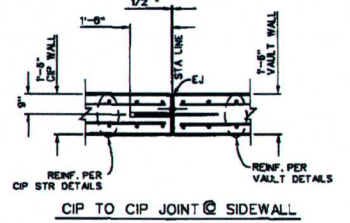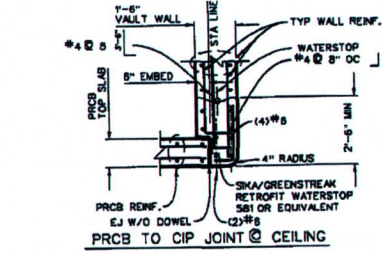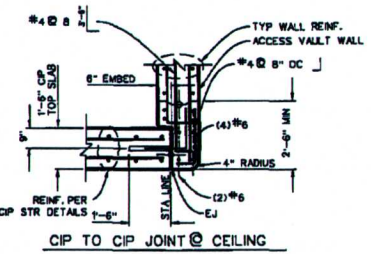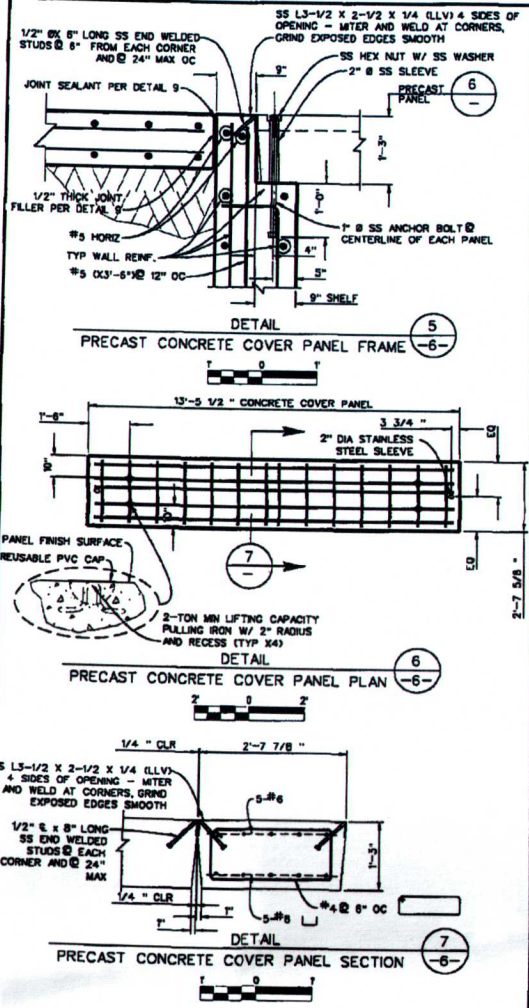

NOTES:

- A FULL CURTAIN OF TRANSVERSE REINFORCING STEEL SHALL BE PLACED THREE INCHES FROM EXPANSION JOINTS.
- LONGITUDINAL STEEL SHALL TERMINATE TWO INCHES FROM EXPANSION JOINTS.

DETAIL

JOINT SUBDETAILS, NO SCALE

AECOM Imagine It. Delivered.

100 Town & Country Road, Orange, CA 92668, USA

T +1-714-567-2501 www.aecom.com



Don't Dig... Until You Call U.S.A. Toll Free 1-888-827-2299

MR. RICH MARK

2-15776

315 W. WARE HWY. W/ RICH'S WOOD WASHING PLANT IN CORNER

N. 2150 S. 341.38

N. 2150 S. 341.38

RAD 83 EPOCH 2019.00

EL. 1,302.15

REVISIONS

NO.	DESCRIPTION	DATE

REVISIONS

NO.	DESCRIPTION	DATE

RIVERSIDE COUNTY FLOOD CONTROL AND WATER CONSERVATION DISTRICT

DESIGNED BY: T. NGUYEN

DRAWN BY: D. PLAZA

DATE ISSUED: JULY 2019

PR. PLAN BY: PR-224502

RECOMMENDED FOR APPROVAL BY: [Signature]

DATE: 7/24/2019

APPROVED BY: [Signature]

DATE: 7/24/2019

ORTEGA CHANNEL RETROFIT STAGE 91

DETAILS - 4





PROJECT NO. 3-0-00070-91

DRAWING NO. 3-0215

SHEET NO. 7 OF 9

CONSTRUCTION DRAWING SET DATED JULY 22, 2019

SHEET NO. 9 OF 9 DRAWING NO. 3-0215 PROJECT NO. 3-0-00070-91	ORTEGA CHANNEL RETROFIT STAGE 91 INTERIM GRADING	DATE: 7/24/2019 DRAWN BY: <i>[Signature]</i> CHECKED BY: <i>[Signature]</i> APPROVED BY: <i>[Signature]</i>	DATE: 7/24/2019 DRAWN BY: <i>[Signature]</i> CHECKED BY: <i>[Signature]</i> APPROVED BY: <i>[Signature]</i>	PROJECT NO. 3-0-00070-91 PROJECT NAME: ORTEGA CHANNEL RETROFIT STAGE 91 PROJECT LOCATION: ORTEGA CHANNEL RETROFIT STAGE 91 PROJECT DESCRIPTION: INTERIM GRADING	CLIENT: AECOM PROJECT: Ortega Channel Retrofit Stage 91 LOCATION: Ortega Channel DATE: 7/24/2019		PROJECT NO. 3-0-00070-91 PROJECT NAME: ORTEGA CHANNEL RETROFIT STAGE 91 PROJECT LOCATION: ORTEGA CHANNEL RETROFIT STAGE 91 PROJECT DESCRIPTION: INTERIM GRADING
		REVERSE COUNTY FLOOD CONTROL DISTRICT WATER CONSERVATION DISTRICT	REVERSE COUNTY FLOOD CONTROL DISTRICT WATER CONSERVATION DISTRICT	REVERSE COUNTY FLOOD CONTROL DISTRICT WATER CONSERVATION DISTRICT	REVERSE COUNTY FLOOD CONTROL DISTRICT WATER CONSERVATION DISTRICT		

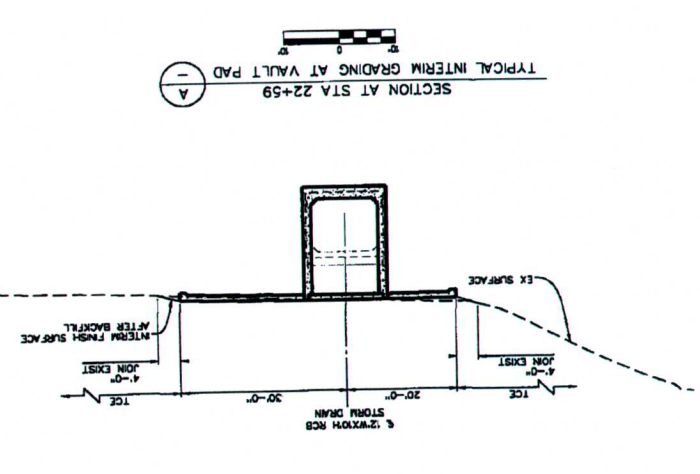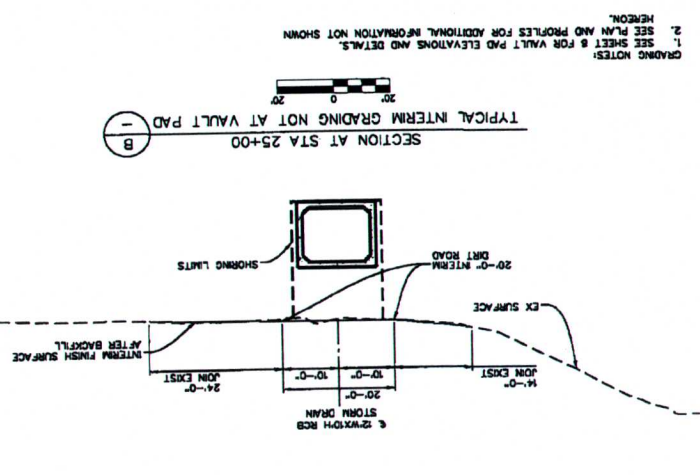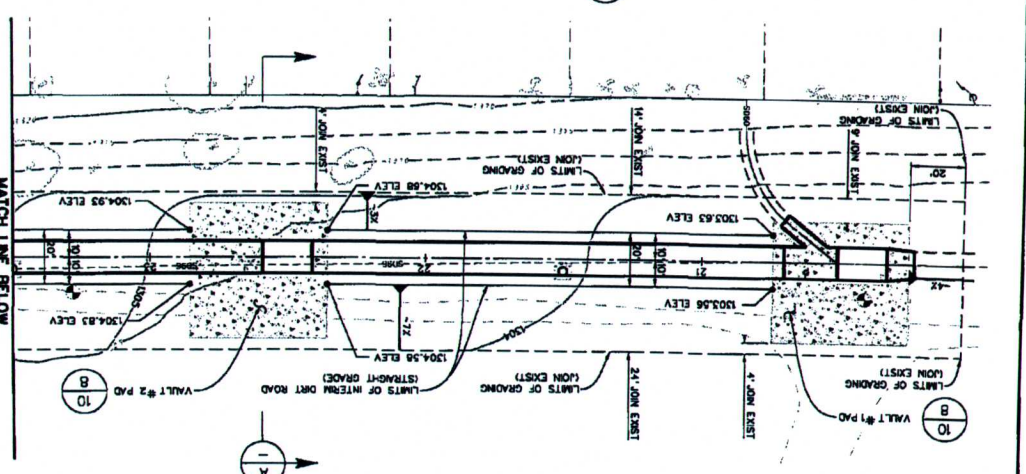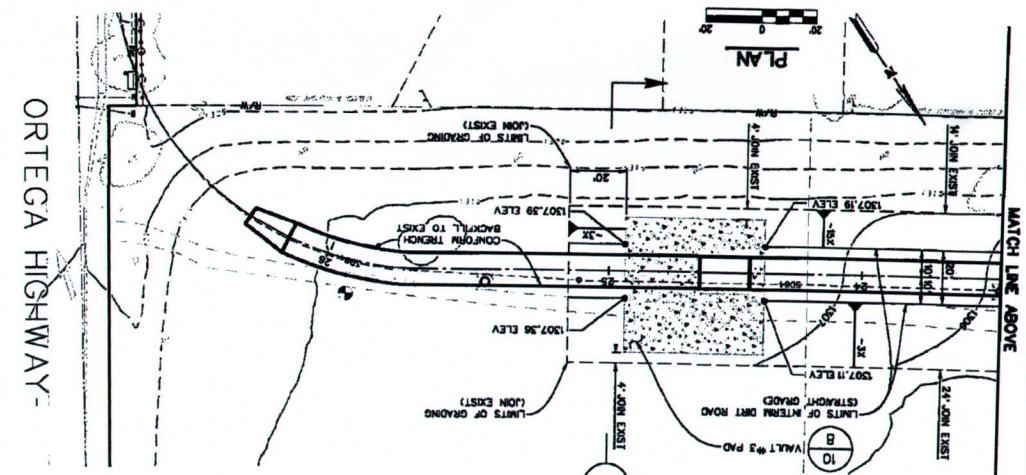

GRADING NOTES:
 1. SEE SHEET 8 FOR VALLT PAD ELEVATIONS AND DETAILS.
 2. SEE PLAN AND PROFILES FOR ADDITIONAL INFORMATION NOT SHOWN HEREON.

CONSTRUCTION DRAWING SET DATED JULY 22, 2019

Exhibit 2

Ortega Channel Retrofit, Stage 91-Change Order No. 1 Extra Work Costs

Extra Work Description	Changed Conditions				
	New Total	Original Total	Net Change	Unit	Total
Downstream Junction Structure 20+22 to 20+70 Demo and Stockpile (Costs/Per Day)	7	3	4	\$15,200	\$60,800
On-Site Labor and Equipment (Costs/Per Day)	21	6.0	15	\$15,200	\$228,000
Demolish, Pulverize Pipe, Separate and Stockpile (Costs/Per Day)	11	0	11	\$9,222	\$101,442
Haul Stockpile and Disposal (Costs/Per Load)	141	46	95	\$524	\$49,758
Total					\$440,000

To be recorded with County Recorder.
No recording fee.

Recording requested by:

Kecia Harper, Clerk of the Board
Riverside County Clerk of the Board
Stop No. 1010
Post Office Box 1147, Riverside, CA 92502-1147

When recorded return to:

CLERK OF THE BOARD
Stop No. 1010
Post Office Box 1147, Riverside, CA 92502-1147

NOTICE OF COMPLETION

(Civil Code § 9204 – Public Works)

2021-0337431

06/03/2021 08:00 AM Fee: \$ 0.00

Page 1 of 1

Recorded in Official Records
County of Riverside
Peter Aidana
Assessor-County Clerk-Recorder



6080

Notice is hereby given by the undersigned owner, a public entity of the State of California, that a public work of improvement has been completed, as follows:

Project title or description of work: **Ortega Channel Retrofit, Stage 91, Project No. 3-0-00070-91**

Date of completion: **On the Date Hereof** MAY 2 5 2021

Nature of owner: **Public Agency**

Interest or estate of owner: **Easement**

Address of owner: **1995 Market Street, Riverside, CA 92501**

Name and address of contractor: **H&H General Contractors, Inc., PO Box 536, Highland, CA 92346-0536**

Street address or legal description of site: **Parcel B: Lots 6 and 8 in Block "C" of the "map showing subdivisions in Elsinore," in the city of Lake Elsinore, County of Riverside, State of California, as shown on a map recorded in Book 8, Page 377 of maps, in the office of the County Recorder of San Diego County, California.**

Dated: MAY 2 5 2021

Owner: RIVERSIDE COUNTY FLOOD CONTROL AND WATER CONSERVATION DISTRICT
(Name of public entity)

By: *Karen S. Spiegel*
KAREN SPIEGEL
Title: Chair, Board of Supervisors for the District

STATE OF CALIFORNIA)
COUNTY OF RIVERSIDE)

I am the Chair of the governing board of the Riverside County Flood Control and Water Conservation District, the public entity which executed the foregoing notice and on whose behalf I make this verification; I have read said notice, know its contents, and the same is true. I certify under penalty of perjury that the foregoing is true and correct.

ATTEST:
Kecia Harper
Clerk of the Board

By: *Mirabella Raso*
Deputy

Executed at Riverside, California on MAY 2 5 2021 (Date)

Karen S. Spiegel
Chair, Board of Supervisors for the District
KAREN SPIEGEL

P8\227794
MT#15135

FORM APPROVED COUNTY COUNSEL
BY *Kristine Bell-Valdez*
KRISTINE BELL-VALDEZ DATE

MAY 2 5 2021 11-1

